

**ORDER GRANTING PERMIT AND RIGHT-OF-WAY
TO CONSTRUCT PIPELINE, ROAD CROSSING, AND/OR ROAD CUT**

Now, on this 8th day of January, 2016 at a regular session of the Commissioners' Court of Clay County, Texas, came on to be considered the application of (contractor) Larga Midstream Services LLC, (address) 4401 North F-35, Ste 303, Denton TX 76201 (telephone #) 940-484-9753, hereafter referred to as "contractor", for a permit and right-of-way to lay, construct, maintain, operate or remove a pipeline, road crossing, and/or road cut, along, over and across or under the public roads, streets, alleyways or highways in the County of Clay, State of Texas, described on the plat attached, and the court having considered such application, it is accordingly ORDERED by the Court:

1. That the County of Clay, State of Texas, does hereby grant the right, privilege and right-of-way to contractor to lay, construct, maintain, operate and/or remove a pipeline, road crossing, and/or road cut, along, over, across or under the public roads, streets, alleyways of the County of Clay, State of Texas, as described in the plat attached.
2. That such pipeline, road crossing, and/or road cut, shall be buried, covered, constructed and maintained as not to interfere with the uses and occupancy of such roads by the public and shall be buried at least three (3') feet below the present barditch on said county road.
3. That any adjustment of said pipeline, road crossing, and/or road cut, required for any state farm to market road or any other improved road would be at 100% percent cost to contractor.
4. That all the rights, privileges and right-of-ways hereinabove mentioned are by this order duly vested in the said contractor, its successors and assigns, without any further grant or procedure.
5. That contractor shall restore roadway and/or right-of-way to its previous condition; and/or shall pay to Clay County, Texas reasonable compensation for the restoration of said roadway and/or right-of-way.

_____ (check if applicable) an agreed payment as reasonable compensation in the amount of \$200.00 payable by contractor to Clay County, Texas.

Agreed and Accepted:

Targa Midstream Services LLC By: Theresa Endsley
Contractor Title


STATE OF TEXAS §

COUNTY OF Denton §

Before me, the undersigned authority, on this day personally appeared Theresa Endsley, known to me to be the person whose name is subscribed to the foregoing instrument and acknowledged to me that he executed the same for the purposes and consideration therein expressed and in the capacity therein stated.


Given under my hand and seal of office this 8th day of January, 2016.

Becky Madden
Notary Public in and for Denton County, Texas

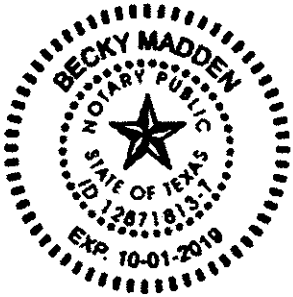

* * * *

Kenneth Liggett
Kenneth Liggett, County Judge

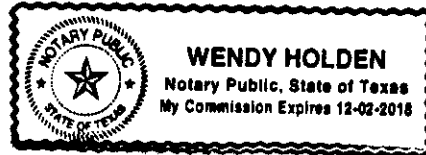

STATE OF TEXAS §


COUNTY OF CLAY §

Before me, the undersigned authority, on this day personally appeared Kenneth Liggett known to me to be the person whose name is subscribed to the foregoing instrument and acknowledged to me that he executed the same for the purposes and consideration therein expressed and in the capacity therein stated.

Given under my hand and seal of office this 25 day of January, 2016.

Notary Public in and for Clay County, Texas

Rife CDP to Prospect

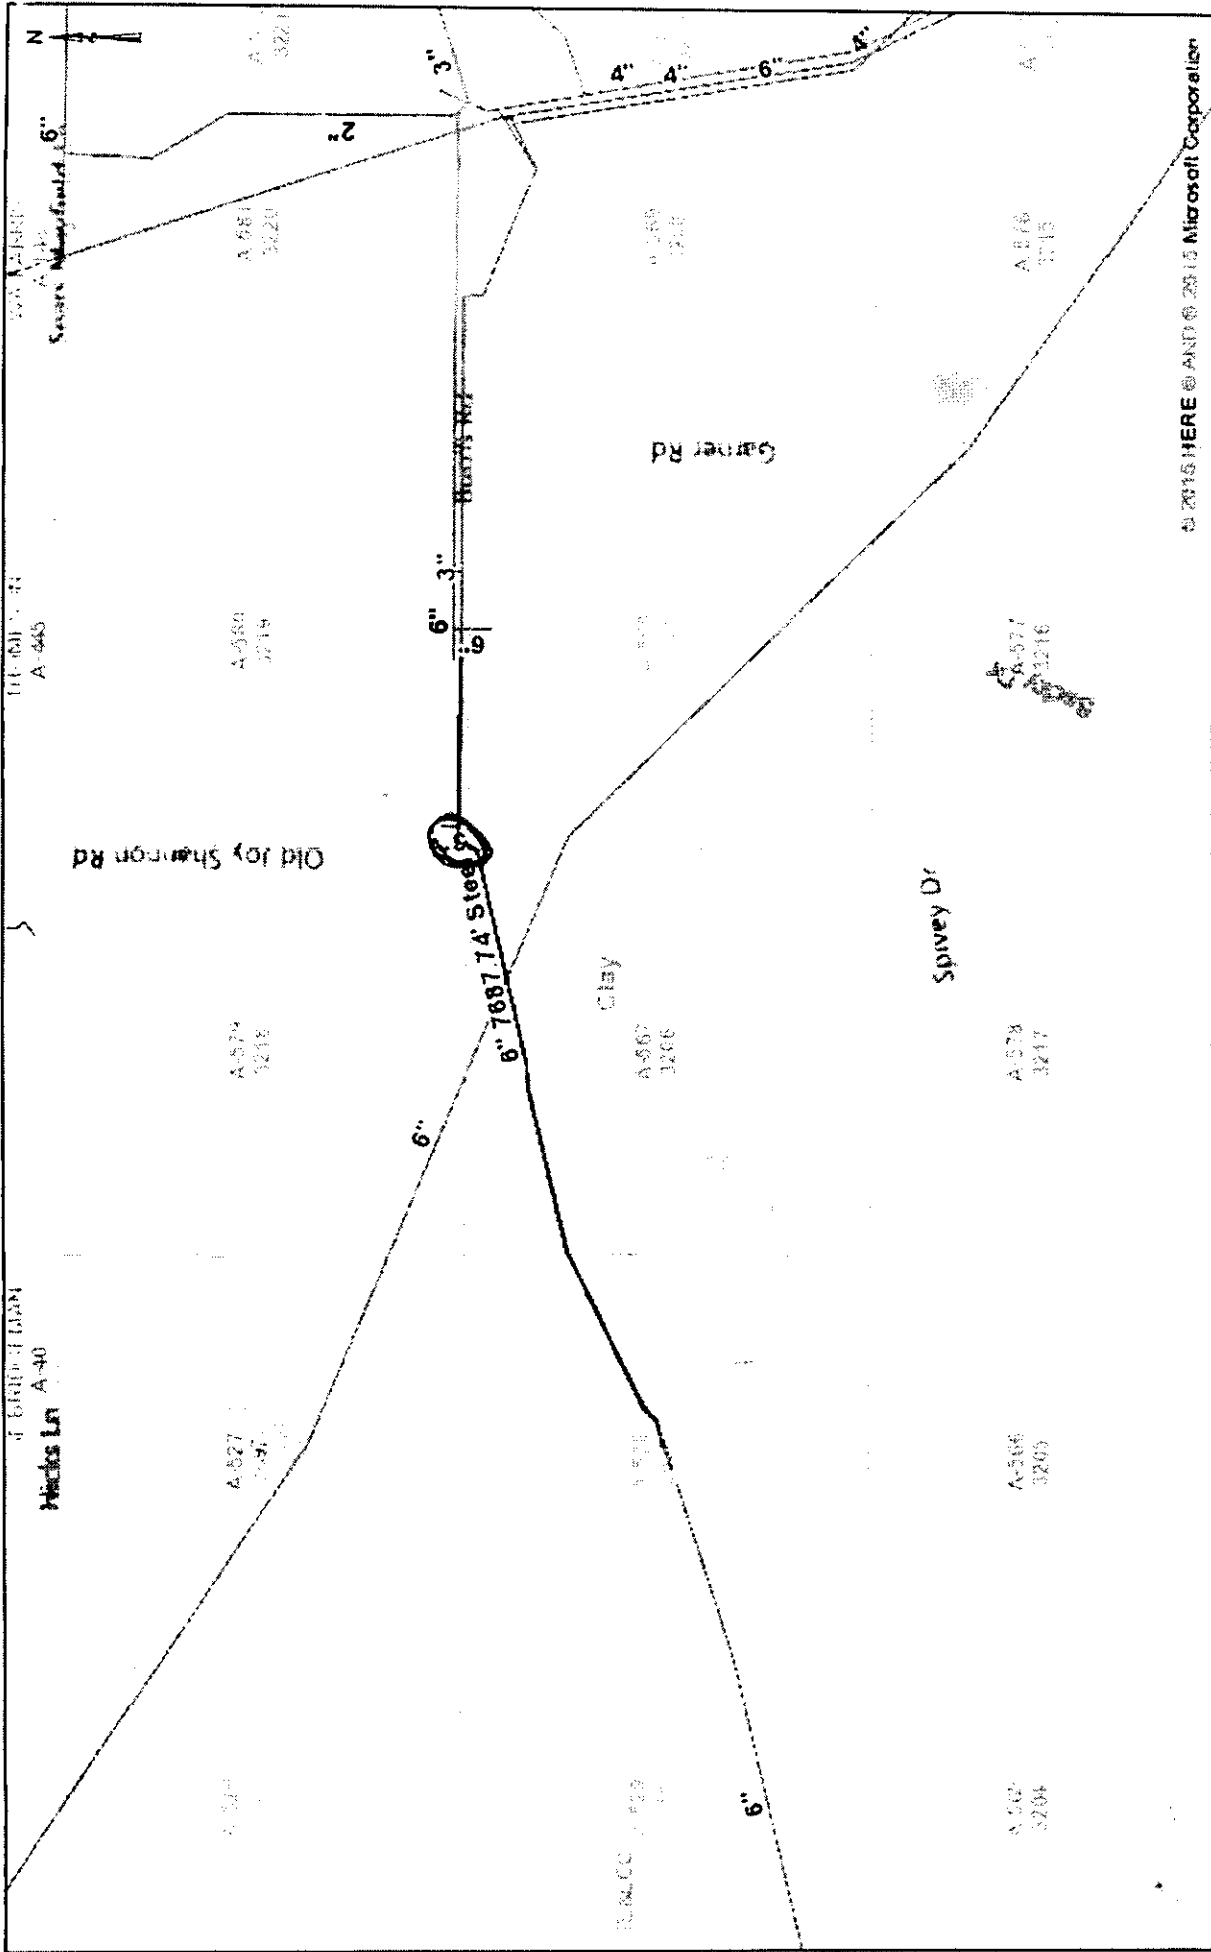


© 2015 HERE @ AND © 2015 Microsoft Corporation

December 15, 2015



Redline Application

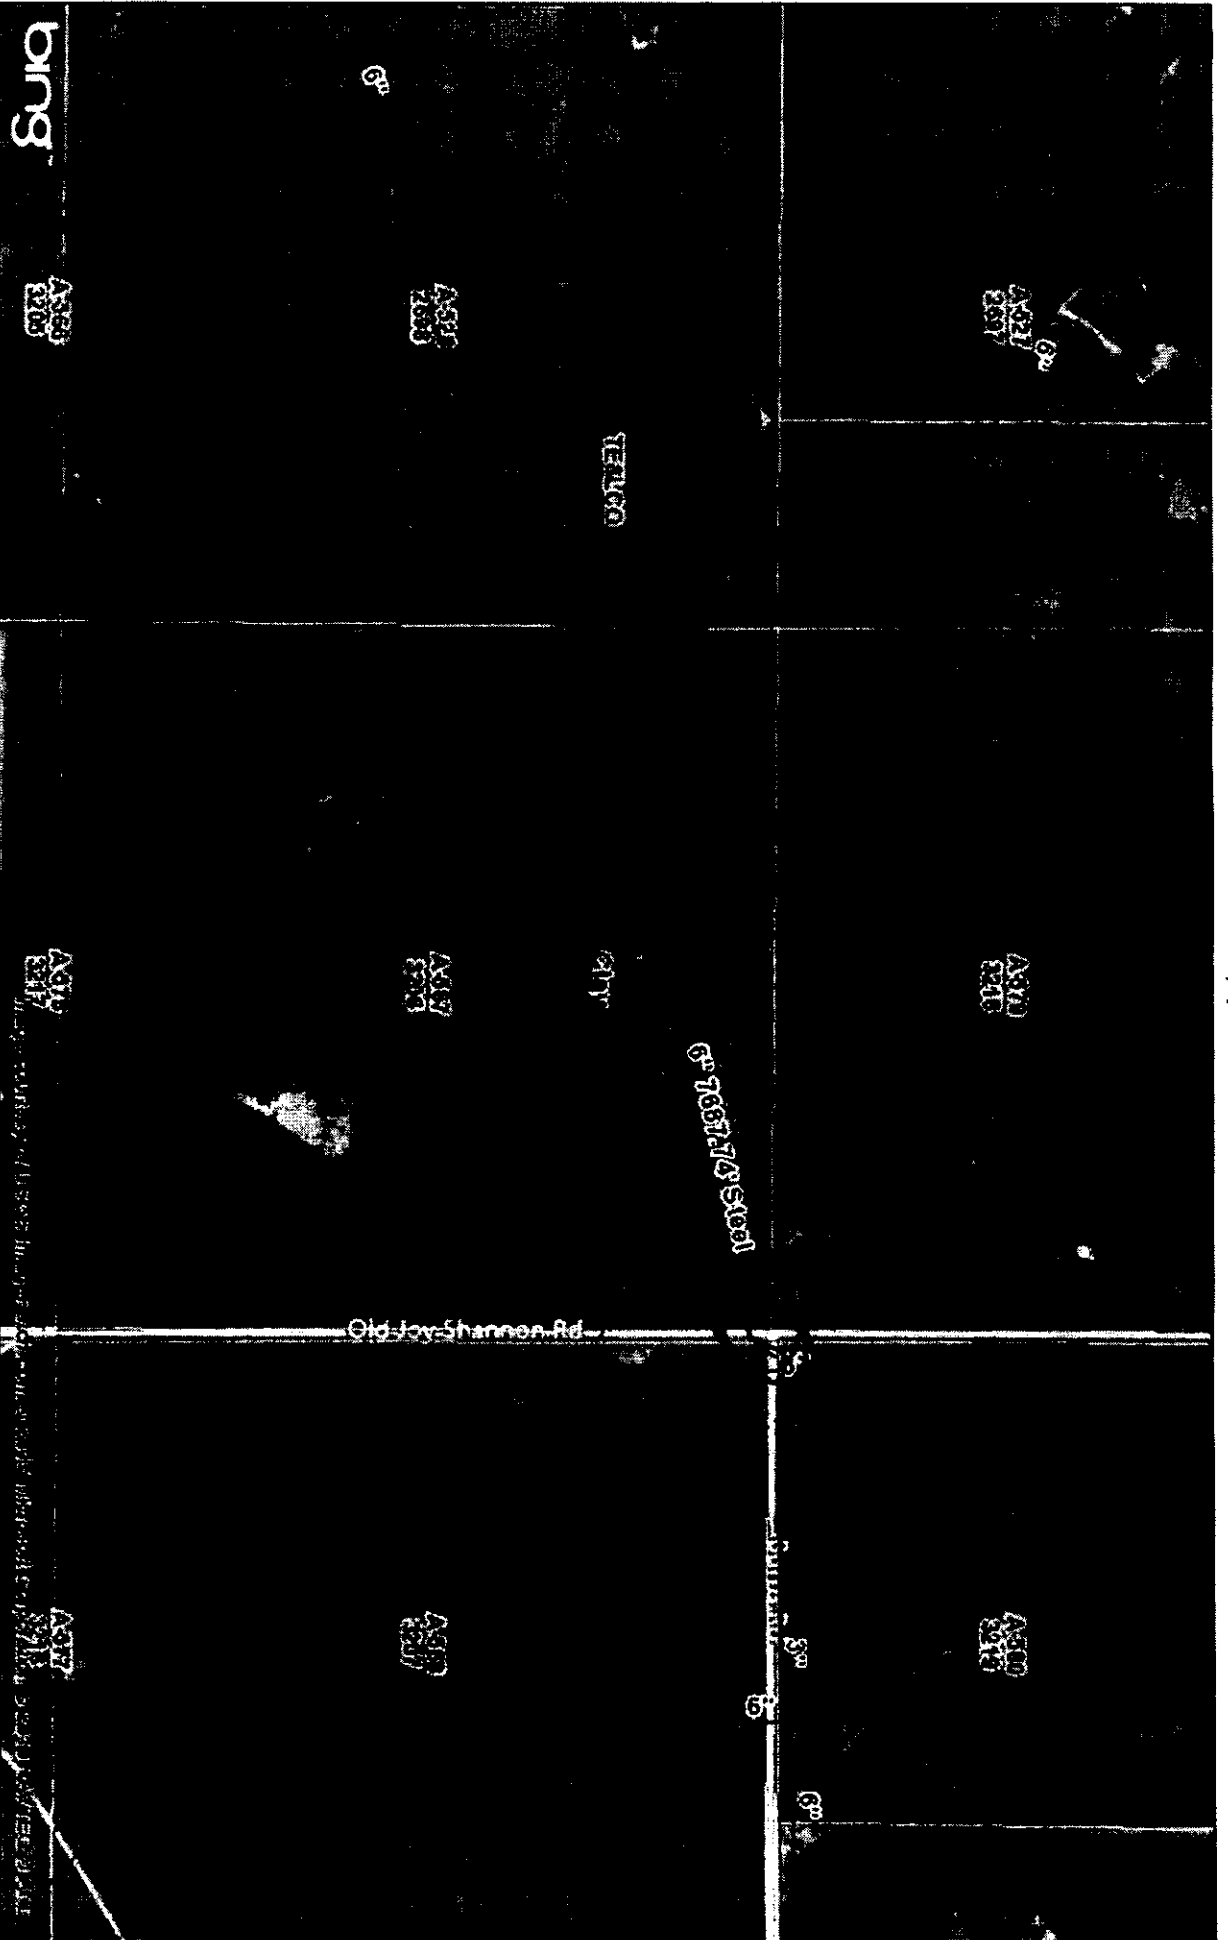

December 15, 2015

0 008 0.12 0.18 0.24



TARGA

Endsley, Theresa M.